
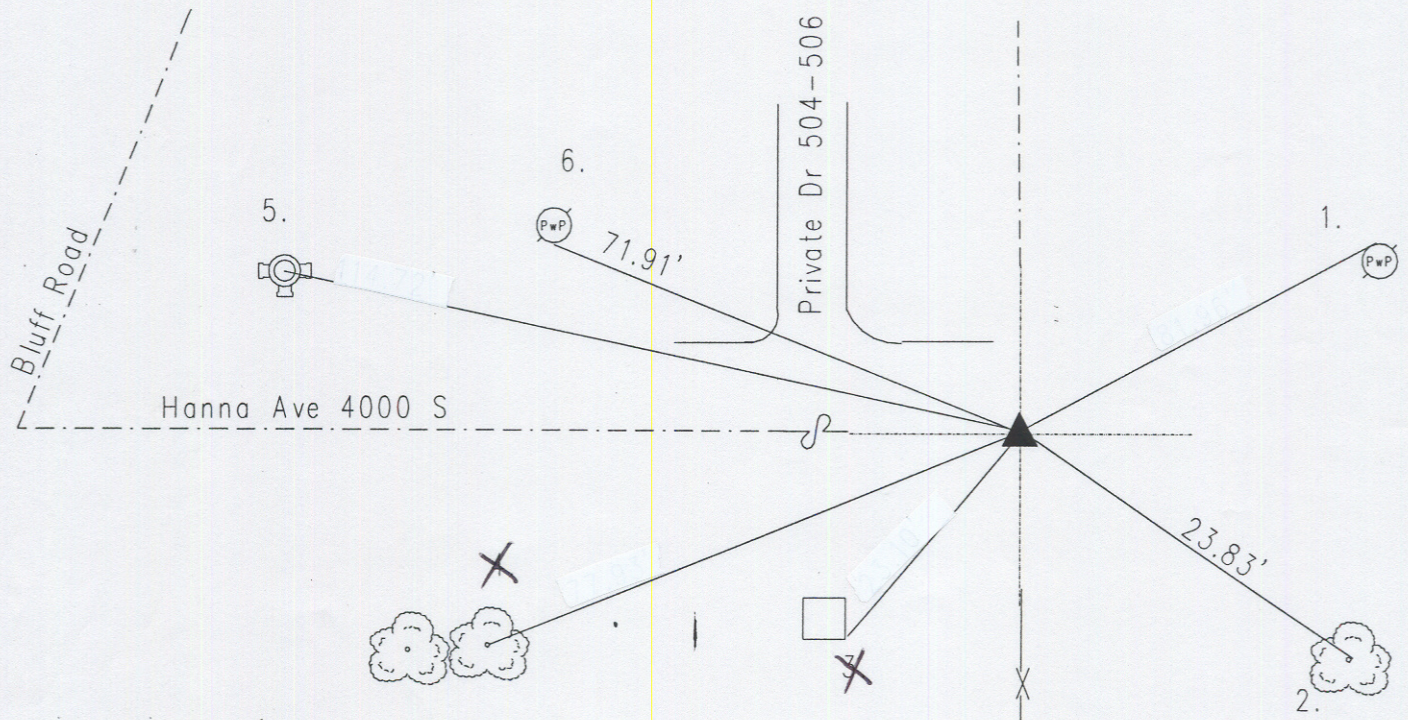


OFFICE OF THE MARION COUNTY SURVEYOR
SECTION RECORD CORNER
SECTION 35 TOWNSHIP 15 RANGE 3
DATE: 9-19-07
PARTY CHIEF: Wilcoxon
CREW: _____
TYPE OF MARKER: Harrison
METHOD OF ESTABLISHMENT: County: 7-29-96

IN. S.P.C. E ZONE, NAD 83
NAME: 15033502
N: 495173.7100(m)
E: 57015.6290(m)

Hanna Ave 4000 S

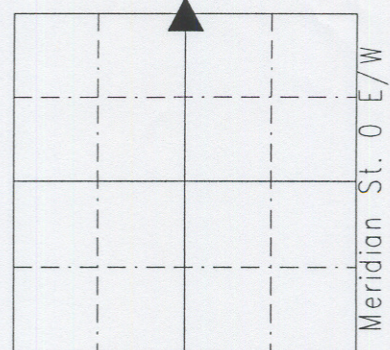

15033502

REF.	DISTANCE	DESCRIPTION
1.	82.17'	PK nail PwP#2-665A 12"up
2.	23.83'	Boat spike w/washer NE 36" red oak 48"up
3.	23.10'	PK nail SE mailbox post 36"up
4.	77.93'	Boat spike w/washer N twin hackberry 48"up
5.	114.80'	Top nut of fire hydrant
6.	71.91'	PK nail S PwP#26-664A 60"up

CORNER HISTORY: Corner originally set as a post in 1820 by Wm. B. Laughlin with witness: 10" elm N 24 W 18 links; 6" sugar S 46 E 17 links per Marion County Atlas pg. 6.

A survey (no date) by P. Hosbrook called found tree and rock; but not quite right per Perry Township Legal Survey Book pg. 15. A survey (no date) by Paul R. Brown called no distances; but did call a stone per Perry Township Legal Survey Book pg. 83. Old tie card (no date) called #40 date nail as corner. Reference dated 3-9-1973 by Scherschel did not give description of corner. Reference dated 6-13-75 by Fortner called #49 date nail.

Reference dated 10-21-75 by R. Miller called railroad spike. Reference dated 6-19-86 by Gries called railroad spike. Reference dated 7-29-96 called dug for railroad spike and found it 3" down; set mag nail on top of it. Referenced dated 6-22-01 as per re-surfacing found railroad spike 5" down, no other points were located; set Harrison where the railroad spike was. Reference dated 9-19-07 by Wilcoxon called Harrison.